


LOCUS MAP
(NOT TO SCALE)

1. FIELD SURVEY FOR SITE ASBUILT CONDUCTED ON DECEMBER 27, 2018.
2. ALL DIMENSIONS ARE PERPENDICULAR TO PROPERTY LINES.
3. PARCEL LIES WITHIN FLOOD ZONE X PER FIRM PANEL #25023C0464J, DATED JULY 17, 2012.
4. PROPERTY LINES DEPICTED ARE FROM LOT 7 ON A PLAN ENTITLED "DEFINITIVE PLAN OF LAND FOR PARADISE MEADOWS" PREPARED BY ATLANTIC DESIGN ENGINEERS, INC. DATED NOVEMBER 13, 1998 AND RECORDED WITH THE PLYMOUTH COUNTY REGISTRY OF DEEDS ON SEPTEMBER 3, 1999 IN PLAN BOOK 42 PAGE 796.

I CERTIFY THAT THIS PLAN DEPICTS SITE ASBUILT CONDITIONS AS THEY EXIST AS OF DECEMBER 27, 2018.

PROFESSIONAL ENGINEER _____ DATE _____

Designed by : _____
Drawn by : _____
Checked by : _____
Survey chk. by : _____
Approved by : _____

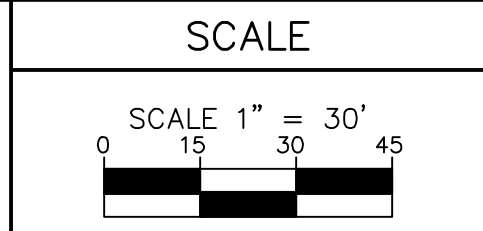

NO.	BY	DATE	REVISION

PREPARED FOR:
MATTHEW DEMANCHE
4 SPARROW LANE
ROCHESTER, MASSACHUSETTS 02770

SITE AS-BUILT PLAN
FOR
4 SPARROW LANE
LOT 7 PARADISE MEADOWS
ROCHESTER, MASSACHUSETTS
JANUARY 2, 2018